


SEC. 14, TWP. 24, N. RING. 1 E, WM
KITSAP COUNTY, WASHINGTON

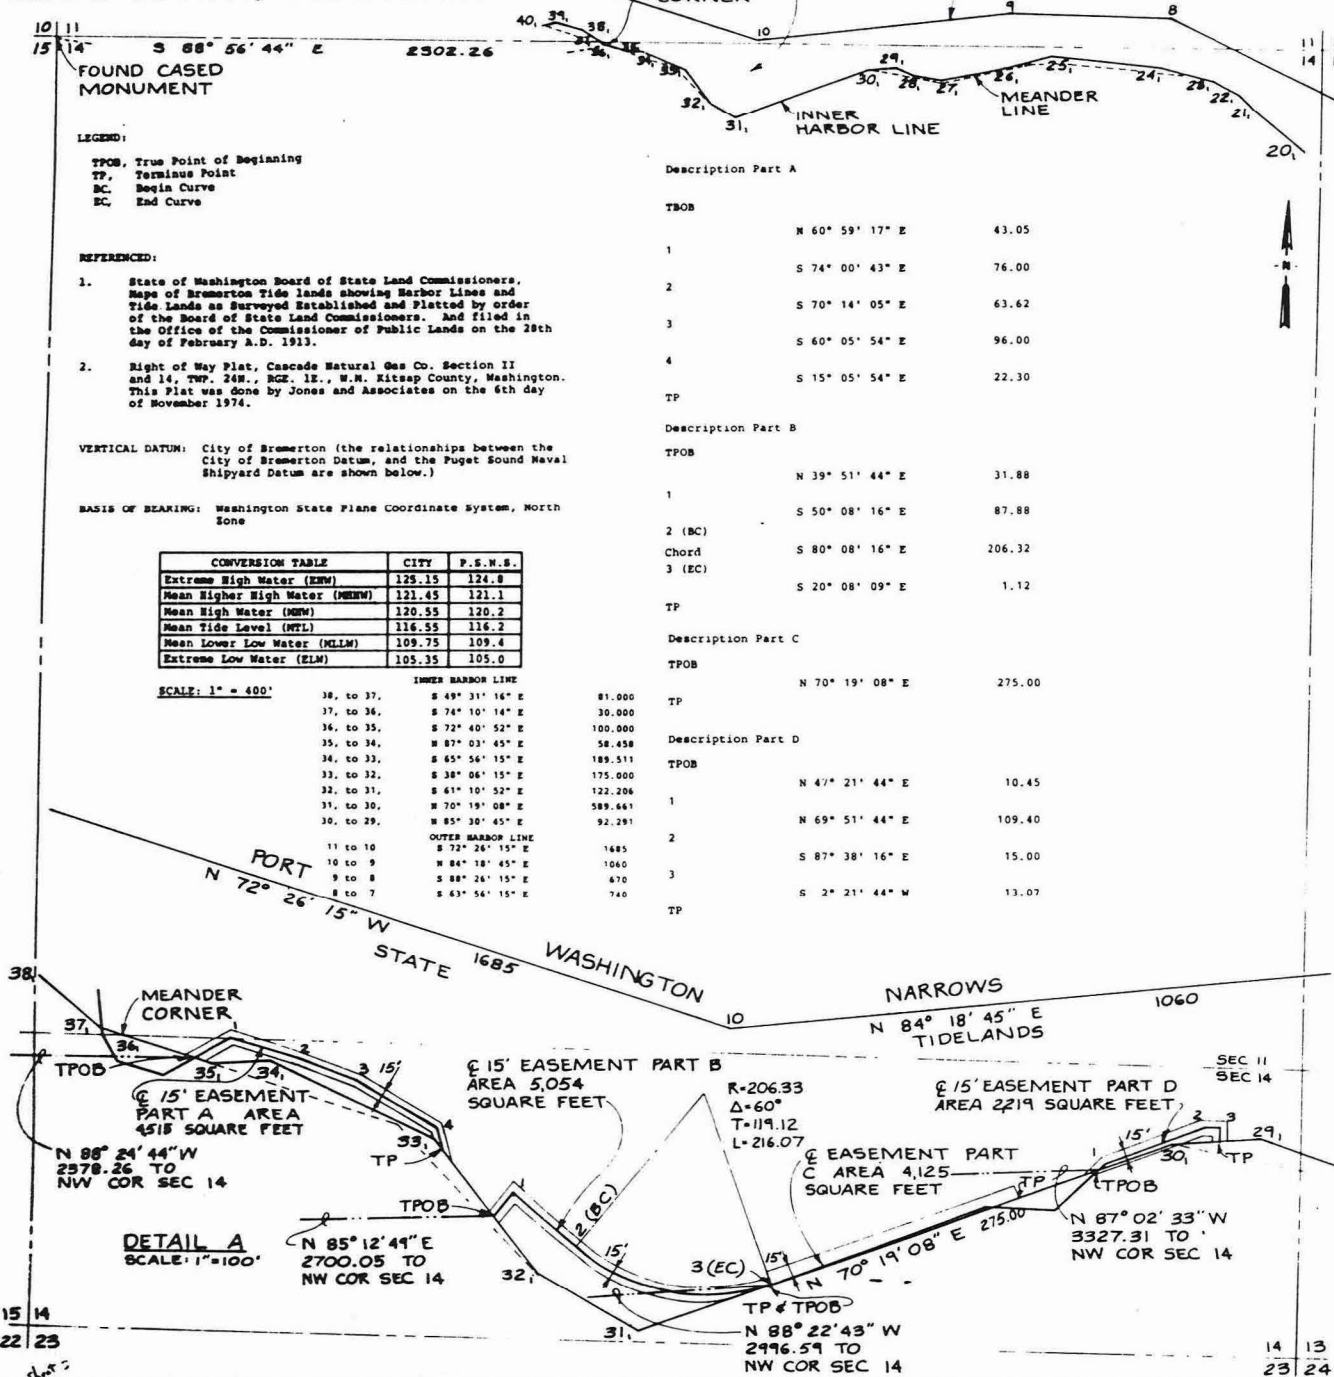

Description of Right-of-Way for Utility Line Across Aquatic State-Owned Lands

PARCEL 2
A strip of land 15 feet in width, 7.5 feet left and right of the following described centerline, situated in Section 14, Township 24 North, Range 1 East, Willamette Meridian, Kitsap County, Washington.

Commencing at the Northwest corner of said Section 14; thence South 88° 24' 44" East 2378.26 feet to a point on the State Inner Harbor Line per State of Washington Board of State Land Commissioners, Maps of Bremerton Tide Lands, 28 February 1913 (Page 5); said point being the True Point of Beginning; thence North 60° 59' 17" East 43.05 feet; thence South 74° 00' 43" East 76.00 feet; thence South 70° 14' 05" East 63.62 feet; thence South 60° 05' 54" East 96.00 feet; thence South 15° 05' 54" East 22.30 feet to a point on the State Inner Harbor line and the Terminus Point of said easement.

PARCEL D
A strip of land 15 feet in width, 7.5 feet left and right of the following described centerline, situated in Section 14, Township 24 North, Range 1 East, Willamette Meridian, Kitsap County, Washington.

Commencing at the Northwest corner of said Section 14, thence South 85° 12' 49" East 2700.05 feet to a point on the State Inner Harbor line per State of Washington Board of State Land Commissioners, Maps of Bremerton Tide Lands, 28 February 1913 (Page 5); said point being the True Point of Beginning; thence North 39° 51' 44" East 31.88 feet; thence South 50° 08' 16" East 87.88 feet; thence along a 27° 46' 08" degree of curve to the left 216.07 feet, said curve having a chord which bears South 80° 08' 16" East 206.32 feet; thence South 20° 08' 09" East 1.12 feet to a point on the State Inner Harbor line and the Terminus Point of said easement.

PARCEL E
A strip of land 15 feet in width, 15 feet left of the following described centerline, situated in Section 14, Township 24 North, Range 1 East, Willamette Meridian, Kitsap County, Washington.


Commencing at the Northwest corner of said Section 14, thence South 84° 22' 43" East 2996.59 feet to a point on the State Inner Harbor line per State of Washington Board of State Land Commissioners, Maps of Bremerton Tide Lands, 28 February 1913 (Page 5); said point being the True Point of Beginning; thence North 70° 19' 08" East along said Inner Harbor line 275.00 feet to the Terminus Point of said easement.

PARCEL F
A strip of land 15 feet in width, 7.5 feet left and right of the following described centerline, situated in Section 14, Township 24 North, Range 1 East, Willamette Meridian, Kitsap County, Washington.

Commencing at the Northwest corner of said Section 14; thence South 87° 02' 33" East 3327.31 feet to a point on the State Inner Harbor line per State of Washington Board of State Land Commissioners, Maps of Bremerton Tide Lands, 28 February 1913 (Page 5); said point being the True Point of Beginning; thence North 47° 21' 44" East 10.45 feet; thence North 69° 51' 44" East 109.40 feet; thence South 87° 38' 16" East 15.00 feet; thence South 2° 21' 44" West 13.07 feet to a point on the State Inner Harbor line and the Terminus Point of said easement.

Except that portion not lying within aquatic state-owned land.

45730

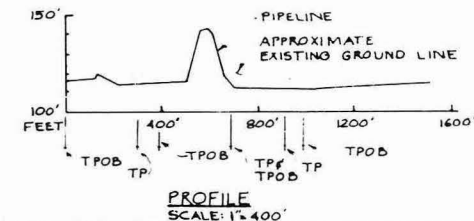

RECORDER'S CERTIFICATE

Filed for record this _____ day of _____, 19____ at _____ N. in Book _____ of Surveys at page _____ at the request of _____
Manager _____ Superintendent of Records _____

SURVEYOR'S CERTIFICATE



This map correctly represents a survey made by me or under my direction in conformance with the requirements of the Survey Recording Act at the request of **CITY OF BREMERTON** in **AUGUST**, 1983.

RECORD SURVEY
for
CITY OF BREMERTON
DNR EASEMENT
PORT WASHINGTON

CH2M HILL
DRAWN BY: WJM CHECKED BY: JLC JOB NO. 512400-WR
DATE: 8-31-83 SCALE: 1" = 400'

BREMERTON-007996